




ISSUE No.	DATE	AMENDMENT
C	24-07-24	ISSUED FOR REPORT
B	18-05-23	ISSUED FOR REPORT
A	10-05-22	ISSUED FOR REPORT

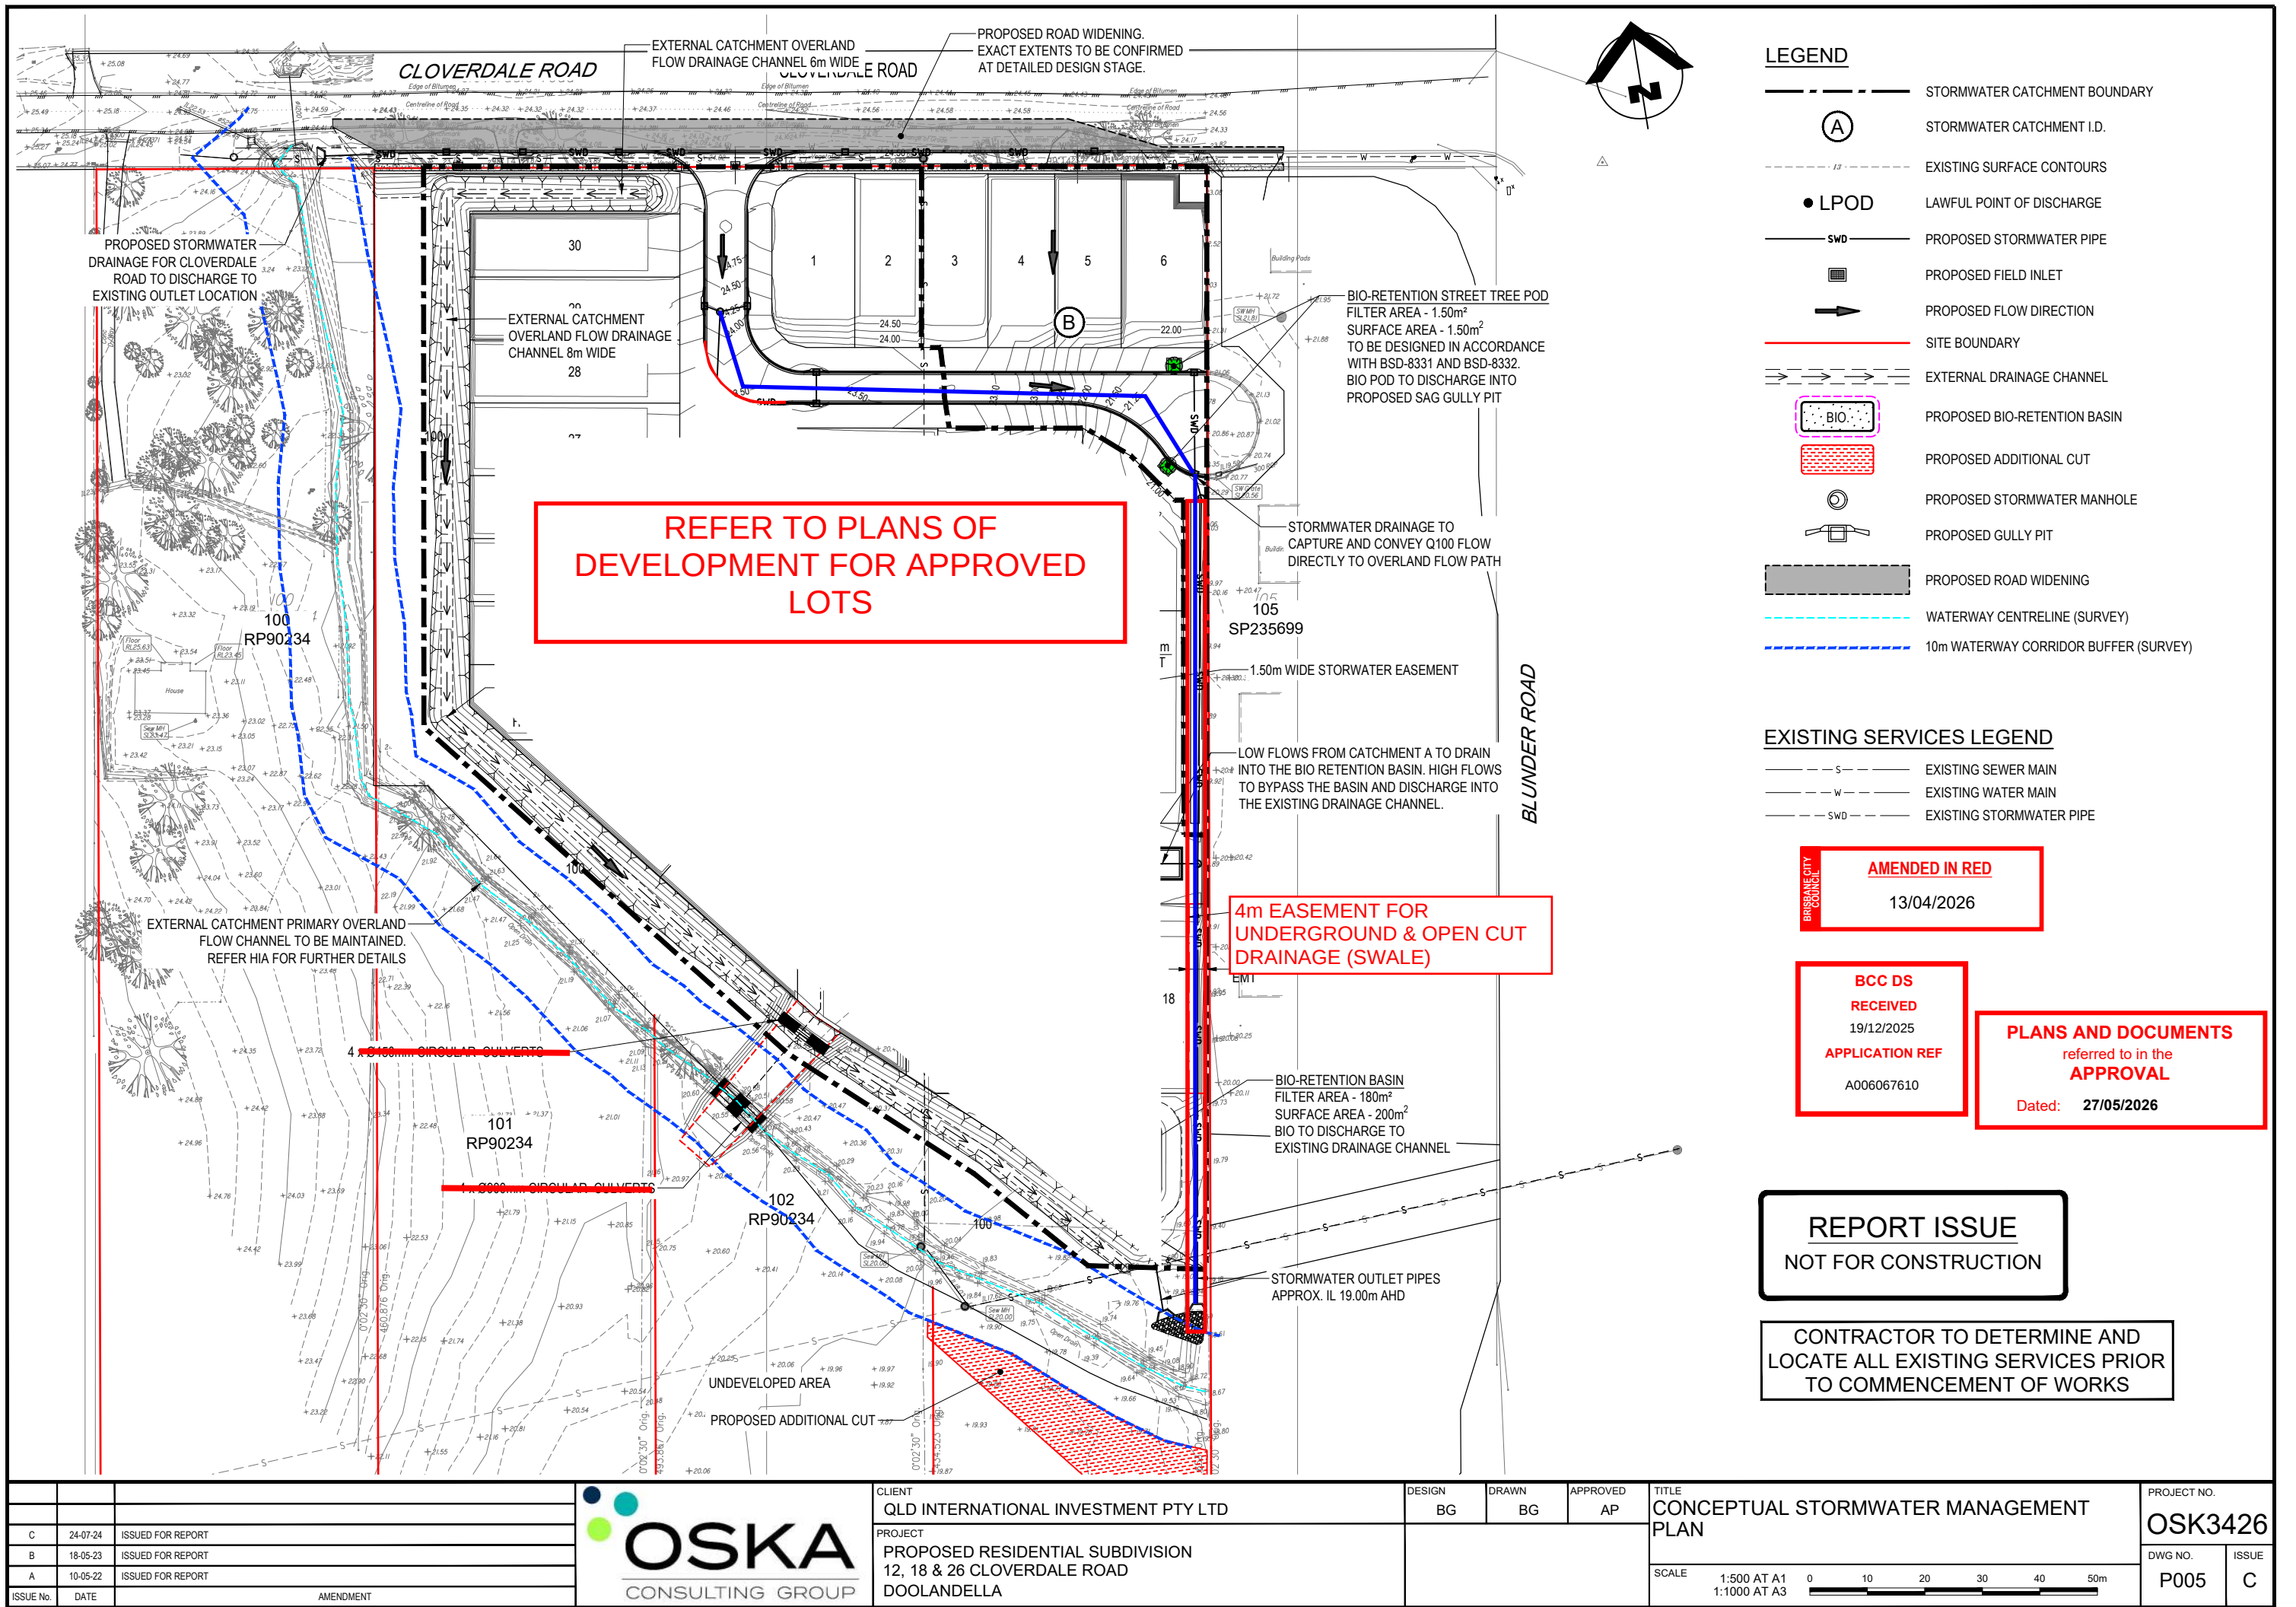

CLIENT	QLD INTERNATIONAL INVESTMENT PTY LTD
PROJECT	PROPOSED RESIDENTIAL SUBDIVISION 12, 18 & 26 CLOVERDALE ROAD DOOLANDELLA

DESIGN	BG
DRAWN	BG
APPROVED	AP

TITLE	CONCEPTUAL STORMWATER MANAGEMENT PLAN
SCALE	1:500 AT A1 1:1000 AT A3

PROJECT NO.	OSK3426
DWG NO.	P005
ISSUE	C