

GENERAL NOTES:

- 1. RETAINING WALL HAS BEEN CONSTRUCTED AND THIS SHEET IS FOR AS BUILT PURPOSE.
- 2. INFORMATION CAPTURED FROM EXISTING BUILDING APPROVAL DRAWINGS AND SITE MEASUREMENT AND PHOTOS.
- 3. REFER TO 202404B SHEET 01~03 FOR FOR CONSTRUCTION DRAWINGS AND DESIGN FORM 15.
- 4. REFER TO FORM 12 ISSUED ON 08/05/2024 FOR CONSTRUCTION CERTIFICATE.

BCC DS

RECEIVED

20/08/2026

APPLICATION REF

A006885222



* drawing to be printed in colour. drawing may not to scale, do not scale on drawings.
* report to engineer if anything suspicious identified, do not guess.
* this drawing copy right reserved and shall not be referred by any other parties. Mozi Engineering or its engineers take no responsibility for the performance of the elements NOT covered by this drawing.




MOZI ENGINEERING PTY LTD
(Residential, Industrial, Commercial)
ABN: 42 673 382 584
PO Box 2182, TINGALPA, QLD 4173
Email: info@moziengineering.com

CLIENT: ----
CLIENT No:
PROJECT:
121 BILL WATSON WY
PALLARA, QLD 4110


----	----	----
1	14.08.2026	AS BUILT ISSUE
ISSUE:	DATE:	REVISIONS
TITLE:		DRAWN: LY
RETAINING WALL PLAN		ENG: AS
		SCALE: N.T.S
JOB No: M26666		SHEET No: S1

** REPORT TO ENGINEER IF ANYTHING SUSPICIOUS IDENTIFIED, DO NOT GUESS **


BCC DS
RECEIVED
20/08/2026
APPLICATION REF
A006885222

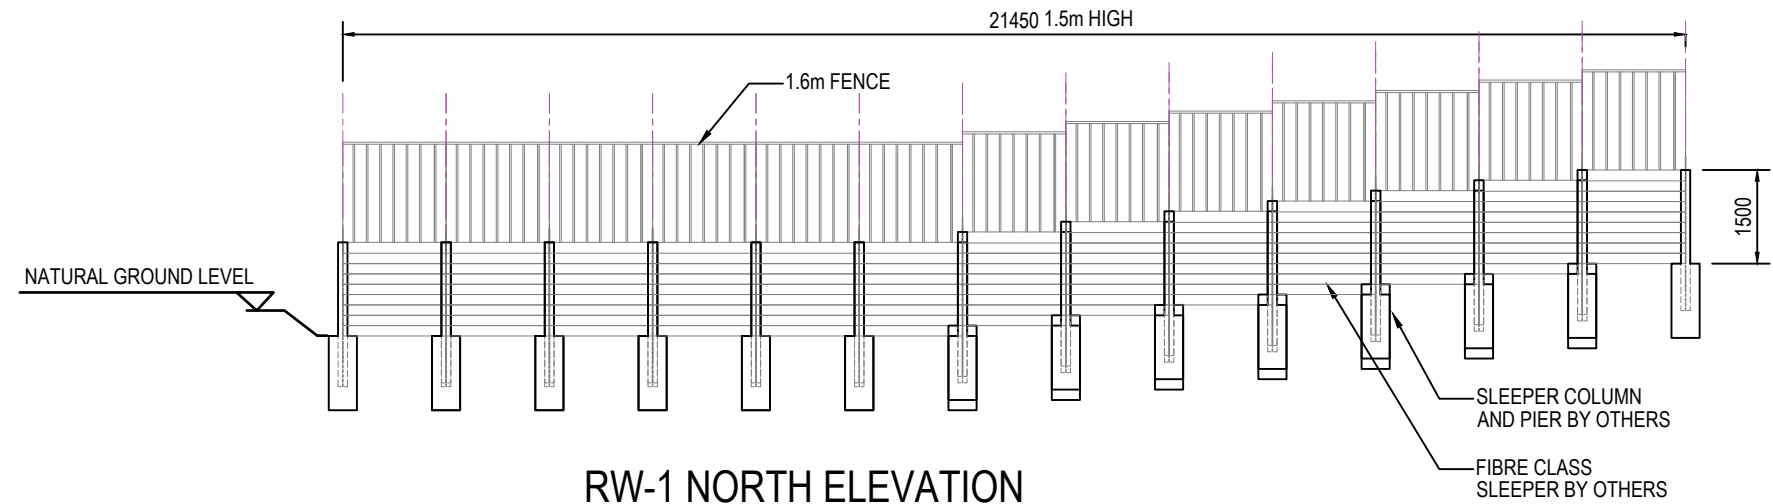


RW-1 NORTH ELEVATION
SCALE 1:100

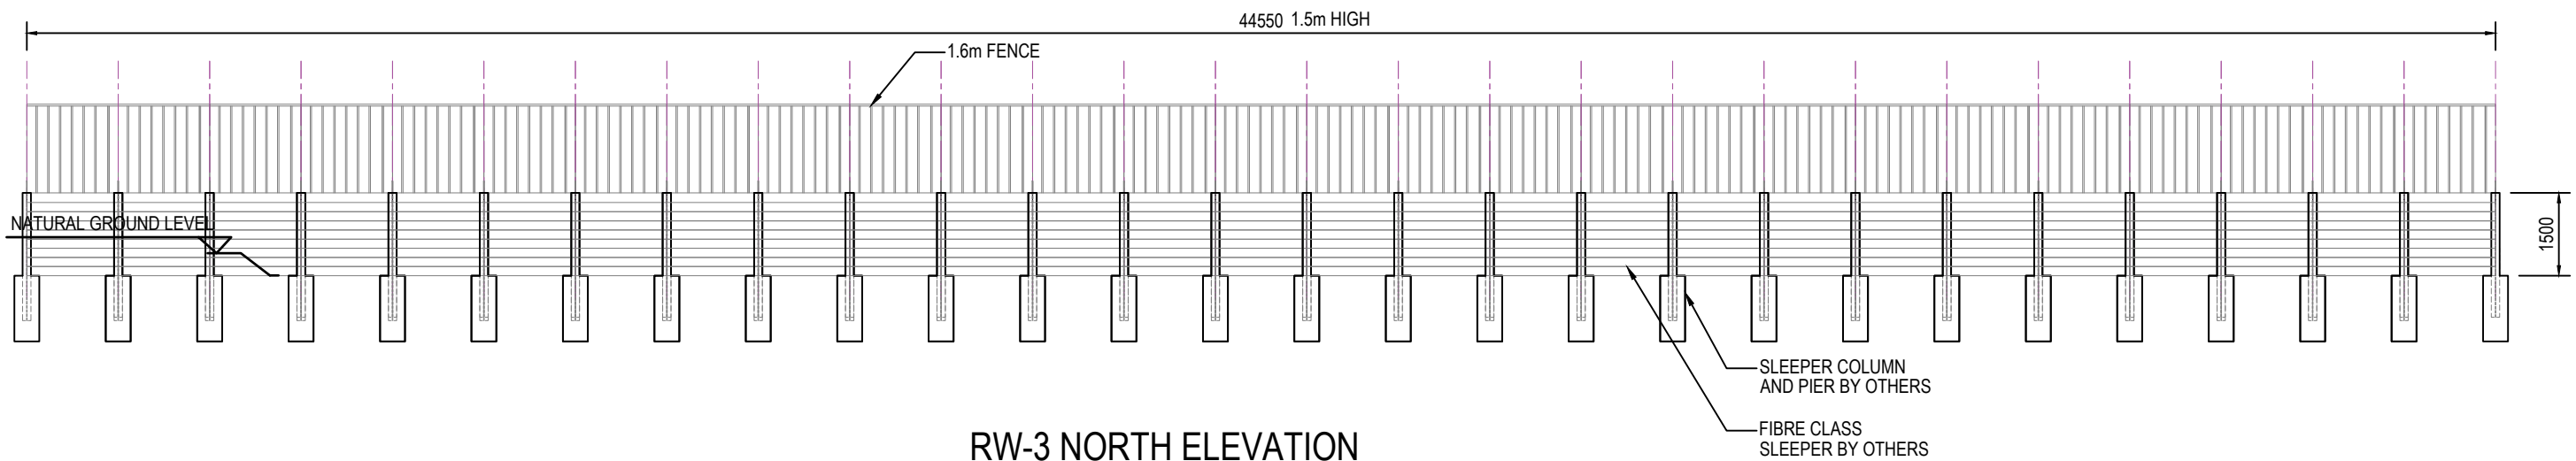

RW-3 NORTH ELEVATION
SCALE 1:100

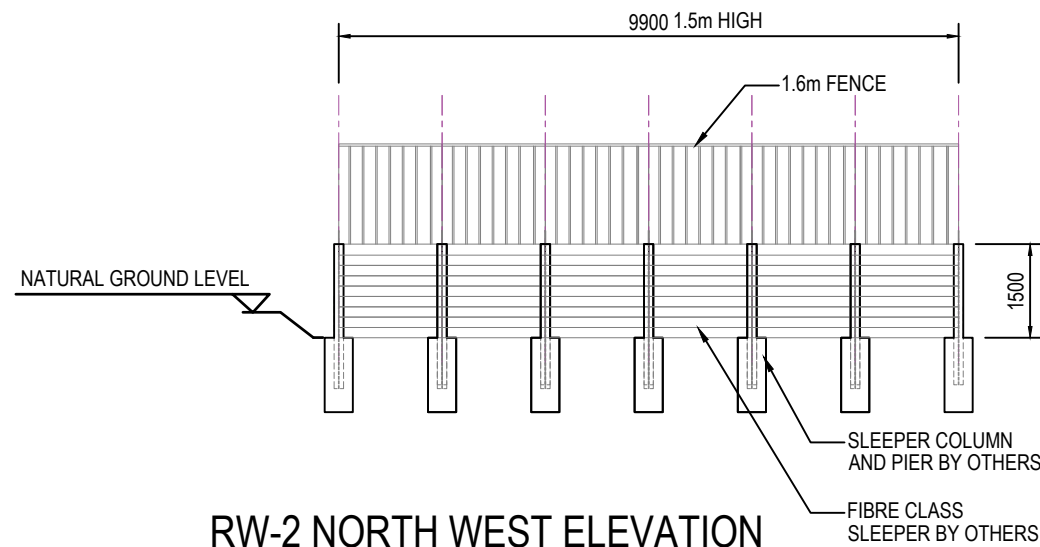

RW-2 NORTH WEST ELEVATION
SCALE 1:100

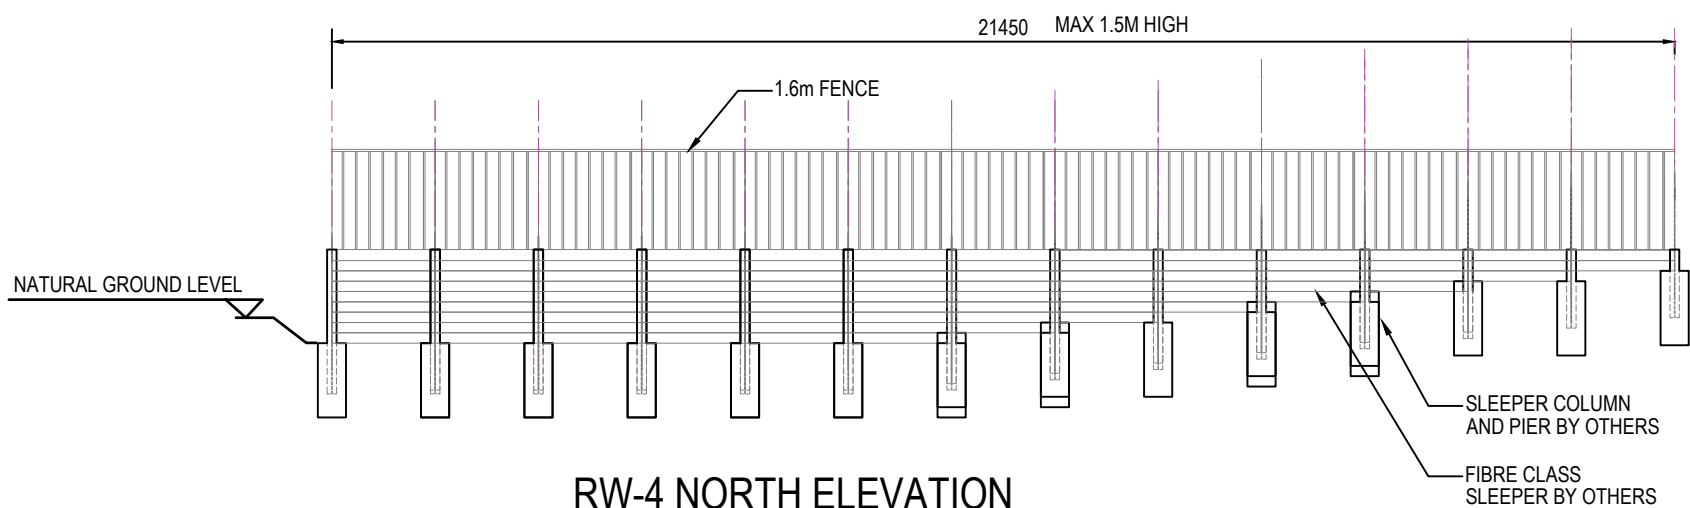

RW-4 NORTH ELEVATION
SCALE 1:100

* drawing to be printed in colour. drawing may not to scale, do not scale on drawings.
* report to engineer if anything suspicious identified, do not guess.
* this drawing copy right reserved and shall not be referred by any other parties. Mozi Engineering or its engineers take no responsibility for the performance of the elements NOT covered by this drawing.



MOZI ENGINEERING PTY LTD
(Residential, Industrial, Commercial)
ABN: 42 673 382 584
PO Box 2182, TINGALPA, QLD 4173
Email: info@moziengineering.com

CLIENT: ----
CLIENT No:
PROJECT:
121 BILL WATSON WY
PALLARA, QLD 4110

---	---	---
1	14.08.2026	AS BUILT ISSUE
ISSUE:	DATE:	REVISIONS
TITLE:		DRAWN: LY
RETAINING WALL ELEVATION		ENG: AS
SCALE:		N.T.S
JOB No:	M26666	SHEET No: S2