Plant North



LEGEND

- PROECT BOUNDARY
- LOT BOUNDARY
- LOT BOUNDARY (SUBJECT TO DEVELOPMENT APPLICATION)

LOT 1 - SP282337 — LOTS SUBJECT TO DEVELOPMENT

Fire Ant Movement Controls

To prevent the spread of fire ants, the Queensland Government has implemented controls that apply to individuals and commercial operators, to restrict the movement of materials that could carry fire ants including soil, turf, potted plants, mulch, baled hay or straw, animal manures, mining or quarry products.

Penalties apply for non-compliance with the movement controls. If you are unsure of your obligations under the Biosecurity Act 2014 contact the relevant Queensland State Government Department.

THIS APPROVAL SHOULD NOT BE TAKEN TO CONSTITUTE PERMISSION TO ENTER NEIGHBOURING PROPERTIES TO CONSTRUCT (INCLUDING ASSOCIATED WORKS SUCH AS DRAINAGE AND EXCAVATION) ANY BUILT TO BOUNDARY WALL OR FENCES. PERMISSION MUST BE OBTAINED FROM RELEVANT PROPERTY OWNERS.

PLANS AND DOCUMENTS
referred to in the
APPROVAL
Dated: **11/12/2025**

BCC DS
RECEIVED
23-OCT-2026
APPLICATION REF
A007138990

BCC DS
RECEIVED
23/09/2025
APPLICATION REF
A006742055

NOTES:
1. PRELIMINARY FOR DEVELOPMENT APPLICATION, NOT FOR TENDER OR CONSTRUCTION.

100 50 0 100 200 300 400m
SCALE 1:5000

ISSUED FOR DA

REFERENCE DRAWINGS		SPECIFICATIONS	No.	REVISION DESCRIPTION	DATE	DRN	CHK
XY24000-02-00-DRG-003	FEEDSTOCK STORAGE AREA		C	RE-ISSUED FOR DEVELOPMENT APPLICATION (DA)	14.08.25	DH	ML
XY24000-02-00-DRG-000	DRAWING LIST FOR DEVELOPMENT APPLICATION		B	ISSUED FOR DEVELOPMENT APPLICATION (DA)	19.02.25	AMC	ML
			A	ISSUED FOR REVIEW	09.01.25	AMC	ML

AMPOL
Ampol Australia Petroleum Pty Ltd
(ABN 17 000 032 128)

COPYRIGHT
THIS DRAWING & DESIGN MUST NOT BE COPIED IN WHOLE OR PART WITHOUT THE WRITTEN CONSENT OF AMPOL AUSTRALIA PETROLEUM PTY LTD.

LYTTON COPROCESSING PROJECT
GENERAL SITE PLAN

MOC. No.	PROJECT No.	EQUIPMENT No.	INDEX.	SIZE.	SITE SAP No.	DRAWING No.	SHEET.	REV.
-	XY24000	-		A1	1124	02-00-DRG-001	0	C

BCC DS
RECEIVED
23/09/2025
APPLICATION REF
A006742055

BCC DS
RECEIVED
23-OCT-2026
APPLICATION REF
A007138990

Plant North

Tank Storage Schedule- Option 1					
Tank ID	Product	Product Classification	Approx. Tank Dimensions*	Fill Volume	Notes
Tank A	Treated RB Tallow, Premium Untreated Tallow, Canola Oil	Combustible C2	4.5m ø x 14.5m H	200KL	New, Vertical, Aboveground, Insulated.
Tank B		Combustible C2	4.5m ø x 14.5m H		New, Vertical, Aboveground, Insulated.
Tank C		Combustible C2	4.5m ø x 14.5m H		New, Vertical, Aboveground, Insulated.
Tank D		Combustible C2	4.5m ø x 14.5m H		New, Vertical, Aboveground, Insulated.
Tank E		Combustible C2	4.5m ø x 14.5m H		New, Vertical, Aboveground, Insulated.
Tank F		Combustible C2	4.5m ø x 14.5m H		New, Vertical, Aboveground, Insulated.
Tank G		Combustible C2	4.5m ø x 14.5m H		New, Vertical, Aboveground, Insulated.
Tank H	Off-spec	Combustible C2	3.5m ø x 6-9m H	50kL	New, Vertical, Aboveground, Insulated.
			Max Storage	1490kL	

*Tank dimensions are approximate and subject to change pending final design from suppliers. All dimensions excluded tank insulation thickness.

Tank Storage Schedule- Option 2					
Tank ID	Product	Product Classification	Approx. Tank Dimensions*	Fill Volume	Notes
Tank A	Treated RB Tallow, Premium Untreated Tallow, Canola Oil	Combustible C2	4.5m ø x 19m H	250KL	New, Vertical, Aboveground, Insulated.
Tank B		Combustible C2	4.5m ø x 19m H		New, Vertical, Aboveground, Insulated.
Tank C		Combustible C2	4.5m ø x 19m H		New, Vertical, Aboveground, Insulated.
Tank D		Combustible C2	4.5m ø x 19m H		New, Vertical, Aboveground, Insulated.
Tank E		Combustible C2	4.5m ø x 19m H		New, Vertical, Aboveground, Insulated.
Tank F		Combustible C2	4.5m ø x 19m H		New, Vertical, Aboveground, Insulated.
Tank G		Nil	Nil		Nil
Tank H	Off-spec	Combustible C2	3.5m ø x 6-9m H	50kL	New, Vertical, Aboveground, Insulated.
Max Storage				1550kL	

*Tank dimensions are approximate and subject to change pending final design from suppliers. All dimensions excluded tank insulation thickness.

LEGEND
PROJECT BOUNDARY
PIPING & UTILITY CORRIDORS (NOTE 3)

NOTES:
1. PRELIMINARY FOR DEVELOPMENT APPLICATION, NOT FOR TENDER OR CONSTRUCTION.
2. THE PROPOSED SITING OF THE PROPOSED DEVELOPMENT FEATURES IS SUBJECT TO REFINEMENT DURING DETAILED DESIGN PHASE.
3. APPROXIMATE SCHEMATIC REPRESENTATION. ROUTING SUBJECT TO CHANGE DURING DETAILED DESIGN. (D)

FEEDSTOCK TANKERS
BAY 1
BAY 2
BAY 3
BAY 4
BAY 5
EXISTING FUEL TANKER TRUCK STAGING AREA
EXISTING FUEL TANKER PARKING AREA
WEEKEND PARKING BAY
WEEKEND PARKING BAY
WEEKEND PARKING BAY
WEEKEND PARKING BAY
EXISTING TANKER TRUCK PARKING AREA CHANGED TO "WEEKEND ONLY"
R6000
3500
6300
EXISTING DIESEL UNLOADING SHELTER, DEMOUNTABLE BUILDING & U/G TANK TO BE REMOVED OR ABANDONED IN SITU. SHOWN IN RED (E)
FUEL TANKERS
TALLOW TANKERS
EXISTING TANK T-5 AND PIT REMOVED (RED) AND REPLACED WITH NEW IN NEW LOCATION SHOWN (BLACK)
PROPOSED UNLOADING BAY "B"
EXISTING CURB
EXISTING CURB
EXISTING INTERNAL FENCE & KERB REALIGNED. EXISTING CARPARKS x 3 REMOVED
NEW CURB LINE
EXISTING VEHICLE EXIT
EXISTING VEHICLE ENTRY
EX BUILDING ANNEX
EXISTING BIODIESEL UNLOADING (TO BE RELOCATED)
PROPOSED COVERED STRUCTURE INCLUDING UNLOADING BAY "A" & WEIGHBRIDGE
EXSITING FIRE HYDRANT & MONITOR RELOCATED TO N/E CORNER OF BAY B
EXSITING FENCE REPLACED/REALIGNED
EXISTING WHITEHOUSE
PROPOSED FILTERS, HEAT EXCHANGER SLAB & SHELTER STRUCTURE
NEW PIPE RACK AND WALKWAYS
NEW U/G SEPARATOR & A/G OILY WATER SEPARATOR TREATMENT
EXSITING UNDERGROUND SERVICE (POWER TO BE REALIGNED)
NEW SWITCHROOM
PROPOSED TANK STORAGE COMPOUND (REFER TO STORAGE SCHEDULE OPTION 1 & 2)
EXSITING POWER (MCC-E/F)
PROPOSED TANK ACCESS STAIR TOWER
PROPOSED PUMPS FOR FEEDSTOCK STORAGE & HANDLING
NEW PIPE RACK
REFER TO CIVIL DRAWINGS FOR PROPOSED EARTHWORKS, PAVEMENTS & DRAINAGE
EXISTING FIRE WATER
SERVICES REALIGNMENT TO EXISTING WHITEHOUSE (D)
CONTINUES ON DRG XY24000-02-00-DRG-004

PLAN VIEW
1:250

5 0 5 10 15 20m
SCALE 1:250

THIS APPROVAL SHOULD NOT BE TAKEN TO CONSTITUTE PERMISSION TO ENTER NEIGHBOURING PROPERTIES TO CONSTRUCT (INCLUDING ASSOCIATED WORKS SUCH AS DRAINAGE AND EXCAVATION) ANY BUILT TO BOUNDARY WALL OR FENCES. PERMISSION MUST BE OBTAINED FROM RELEVANT PROPERTY OWNERS.

PLANS AND DOCUMENTS
referred to in the
APPROVAL
Dated: 11/12/2025

Fire Ant Movement Controls

To prevent the spread of fire ants, the Queensland Government has implemented controls that apply to individuals and commercial operators, to restrict the movement of materials that could carry fire ants including soil, turf, potted plants, mulch, baled hay or straw, animal manures, mining or quarry products.

Penalties apply for non-compliance with the movement controls. If you are unsure of your obligations under the Biosecurity Act 2014 contact the relevant Queensland State Government Department.

ISSUED FOR DA

No.	REVISION DESCRIPTION	DATE	DRN	CHK
E	RE-ISSUED FOR DEVELOPMENT APPLICATION (NOTE AMMENDED)	09.09.25	DH	ML
D	RE-ISSUED FOR DEVELOPMENT APPLICATION (DA)	07.08.25	DH	ML
C	ISSUED FOR DEVELOPMENT APPLICATION (DA)	04.03.25	AMC	ML
B	ISSUED FOR DEVELOPMENT APPLICATION (DA)	19.02.25	AMC	ML
A	ISSUED FOR REVIEW	09.01.25	AMC	ML

REFERENCE DRAWINGS
XY24000-02-00-DRG-000 DRAWING LIST FOR DEVELOPMENT APPLICATION

SPECIFICATIONS

AMPOL
Ampol Australia Petroleum Pty Ltd
(ABN 17 000 032 128)

COPYRIGHT
THIS DRAWING & DESIGN MUST NOT BE COPIED IN WHOLE OR PART WITHOUT THE WRITTEN CONSENT OF AMPOL AUSTRALIA PETROLEUM PTY LTD.

LYTTON COPROCESSING PROJECT
FEEDSTOCK STORAGE AREA
GENERAL ARRANGEMENT

MOC. No.	PROJECT No.	EQUIPMENT No.	INDEX.	SIZE.	SITE SAP No.	DRAWING No.	SHEET.	REV.
-	XY24000	-		A1	1124	02-00-DRG-003	0	E

Plant North



PLAN VIEW

LEGEND

—·—·— PROJECT BOUNDARY

— — — ABOVE GROUND PIPE

NOTES:
1. PRELIMINARY FOR DEVELOPMENT APPLICATION, NOT FOR TENDER OR CONSTRUCTION.
2. THE PROPOSED SITING OF THE PROPOSED DEVELOPMENT FEATURES IS SUBJECT TO REFINEMENT DURING DETAILED DESIGN PHASE.
3. TYPICALLY RUN PER FIGURE 1 OR BY EXTENSION TO EXISTING ABOVE GROUND PIPE SUPPORT. PIPE LENGTH ON GROUND APPROX 680m. FINAL LENGTH SUBJECT TO DETAILED DESIGN PHASE.

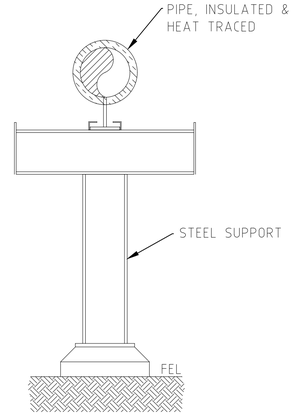

FIGURE 1

THIS APPROVAL SHOULD NOT BE TAKEN TO CONSTITUTE PERMISSION TO ENTER NEIGHBOURING PROPERTIES TO CONSTRUCT (INCLUDING ASSOCIATED WORKS SUCH AS DRAINAGE AND EXCAVATION) ANY BUILT TO BOUNDARY WALL OR FENCES. PERMISSION MUST BE OBTAINED FROM RELEVANT PROPERTY OWNERS.

Fire Ant Movement Controls

To prevent the spread of fire ants, the Queensland Government has implemented controls that apply to individuals and commercial operators, to restrict the movement of materials that could carry fire ants including soil, turf, potted plants, mulch, baled hay or straw, animal manures, mining or quarry products.

Penalties apply for non-compliance with the movement controls. If you are unsure of your obligations under the Biosecurity Act 2014 contact the relevant Queensland State Government Department.

BCC DS
RECEIVED
23-OCT-2026
APPLICATION REF
A007138990

PLANS AND DOCUMENTS
referred to in the
APPROVAL
Dated: **11/12/2025**

BCC DS
RECEIVED
23/09/2025
APPLICATION REF
A006742055

20 10 0 20 40 60 80m
SCALE 1:1000

REFERENCE DRAWINGS		SPECIFICATIONS	No.	REVISION DESCRIPTION	DATE	DRN	CHK
XY24000-02-00-DRG-003	FEEDSTOCK STORAGE AREA		C	RE-ISSUED FOR DEVELOPMENT APPLICATION (DA)	14.08.25	DH	ML
XY24000-02-00-DRG-000	DRAWING LIST FOR DEVELOPMENT APPLICATION		B	ISSUED FOR DEVELOPMENT APPLICATION (DA)	19.02.25	AMC	ML
			A	ISSUED FOR REVIEW	09.01.25	AMC	ML

AMPOL
Ampol Australia Petroleum Pty Ltd
(ABN 17 000 032 128)

COPYRIGHT
THIS DRAWING & DESIGN MUST NOT BE COPIED IN WHOLE OR PART WITHOUT THE WRITTEN CONSENT OF AMPOL AUSTRALIA PETROLEUM PTY LTD.

LYTTON COPROCESSING PROJECT
FEEDSTOCK PIPE TO REFINERY DHTU2
GENERAL ARRANGEMENT

MOC. No.	PROJECT No.	EQUIPMENT No.	INDEX.	SIZE.	SITE SAP No.	DRAWING No.	SHEET.	REV.
-	XY24000	-		A1	1124	02-00-DRG-004	0	C

Plant North

LEGEND:

PATH 1 - TALLOW TANKER DRIVE THROUGH BOTH BAYS & EXITING FACILITY

PATH 2 - TALLOW TANKER DRIVE THROUGH BAY "B" BYPASS BAY "A"

PATH 3 - FUEL TANKER BYPASS TALLOW FACILITY & ENTER EXISTING FACILITY

NOTES:
1. PRELIMINARY FOR DEVELOPMENT APPLICATION, NOT FOR TENDER OR CONSTRUCTION.
2. THE PROPOSED SITING OF THE PROPOSED DEVELOPMENT FEATURES IS SUBJECT TO REFINEMENT DURING DETAILED DESIGN PHASE.
3. TRUCK SWEPT PATH ANALYSIS ARE BASED ON 25m Lg B-DOUBLE, UTILISING AUTOCAD VEHICLE TRACKING SOFTWARE

PLANS AND DOCUMENTS
referred to in the
APPROVAL
Dated: **11/12/2025**

BCC DS
RECEIVED
23-OCT-2026
APPLICATION REF
A007138990

BCC DS
RECEIVED
23/09/2025
APPLICATION REF
A006742055

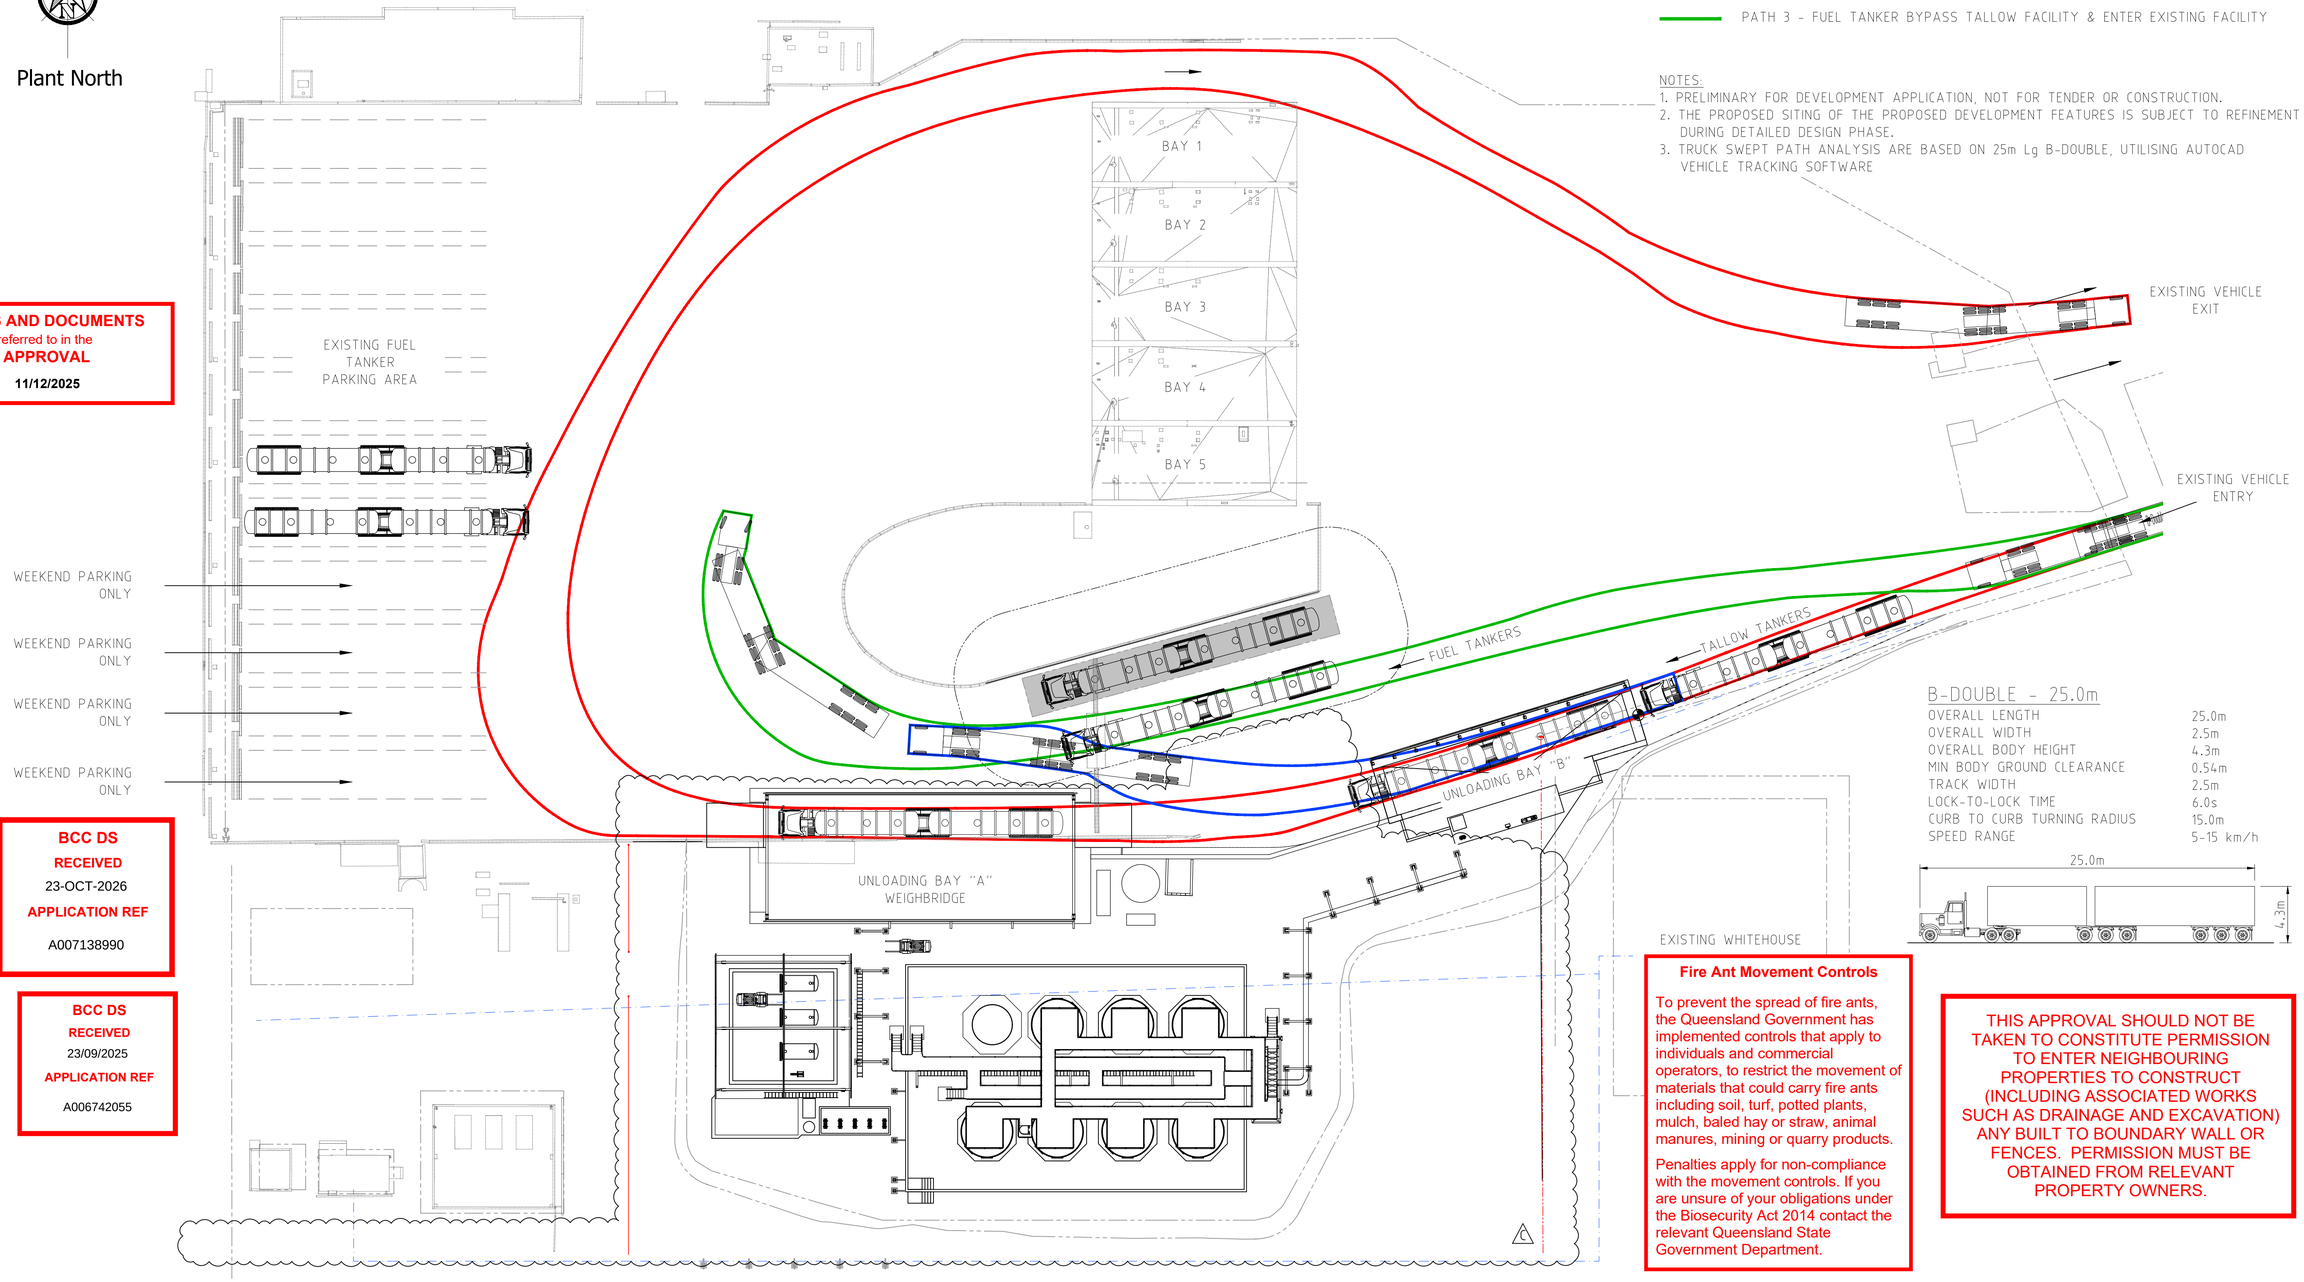

PLAN VIEW
1:250

5 0 5 10 15 20m
SCALE 1:250

B-DOUBLE - 25.0m

OVERALL LENGTH	25.0m
OVERALL WIDTH	2.5m
OVERALL BODY HEIGHT	4.3m
MIN BODY GROUND CLEARANCE	0.54m
TRACK WIDTH	2.5m
LOCK-TO-LOCK TIME	6.0s
CURB TO CURB TURNING RADIUS	15.0m
SPEED RANGE	5-15 km/h

Fire Ant Movement Controls

To prevent the spread of fire ants, the Queensland Government has implemented controls that apply to individuals and commercial operators, to restrict the movement of materials that could carry fire ants including soil, turf, potted plants, mulch, baled hay or straw, animal manures, mining or quarry products.

Penalties apply for non-compliance with the movement controls. If you are unsure of your obligations under the Biosecurity Act 2014 contact the relevant Queensland State Government Department.

THIS APPROVAL SHOULD NOT BE TAKEN TO CONSTITUTE PERMISSION TO ENTER NEIGHBOURING PROPERTIES TO CONSTRUCT (INCLUDING ASSOCIATED WORKS SUCH AS DRAINAGE AND EXCAVATION) ANY BUILT TO BOUNDARY WALL OR FENCES. PERMISSION MUST BE OBTAINED FROM RELEVANT PROPERTY OWNERS.

ISSUED FOR DA

No.	REVISION DESCRIPTION	DATE	DRN	CHK
C	RE-ISSUED FOR DEVELOPMENT APPLICATION (DA)	06.08.25	DH	ML
B	ISSUED FOR DEVELOPMENT APPLICATION (DA)	19.02.25	AMC	ML
A	ISSUED FOR REVIEW	09.01.25	AMC	ML

REFERENCE DRAWINGS	
XY24000-02-00-DRG-003	FEEDSTOCK STORAGE AREA
XY24000-02-00-DRG-000	DRAWING LIST FOR DEVELOPMENT APPLICATION

SPECIFICATIONS

AMPOL
Ampol Australia Petroleum Pty Ltd
(ABN 17 000 032 128)

COPYRIGHT
THIS DRAWING & DESIGN MUST NOT BE COPIED IN WHOLE OR PART WITHOUT THE WRITTEN CONSENT OF AMPOL AUSTRALIA PETROLEUM PTY LTD.

LYTTON COPROCESSING PROJECT
FEEDSTOCK STORAGE AREA
VEHICLE SWEPT PATH ARRAGEMENT

MOC. No.	PROJECT No.	EQUIPMENT No.	INDEX.	SIZE.	SITE SAP No.	DRAWING No.	SHEET.	REV.
-	XY24000	-		A1	1124	02-00-DRG-005	0	C

BCC DS
RECEIVED
23/09/2025
APPLICATION REF
A006742055

THIS APPROVAL SHOULD NOT BE TAKEN TO CONSTITUTE PERMISSION TO ENTER NEIGHBOURING PROPERTIES TO CONSTRUCT (INCLUDING ASSOCIATED WORKS SUCH AS DRAINAGE AND EXCAVATION) ANY BUILT TO BOUNDARY WALL OR FENCES. PERMISSION MUST BE OBTAINED FROM RELEVANT PROPERTY OWNERS.

Fire Ant Movement Controls

To prevent the spread of fire ants, the Queensland Government has implemented controls that apply to individuals and commercial operators, to restrict the movement of materials that could carry fire ants including soil, turf, potted plants, mulch, baled hay or straw, animal manures, mining or quarry products.

Penalties apply for non-compliance with the movement controls. If you are unsure of your obligations under the Biosecurity Act 2014 contact the relevant Queensland State Government Department.

Tank structures (including access ladders) not to exceed 23m in height.

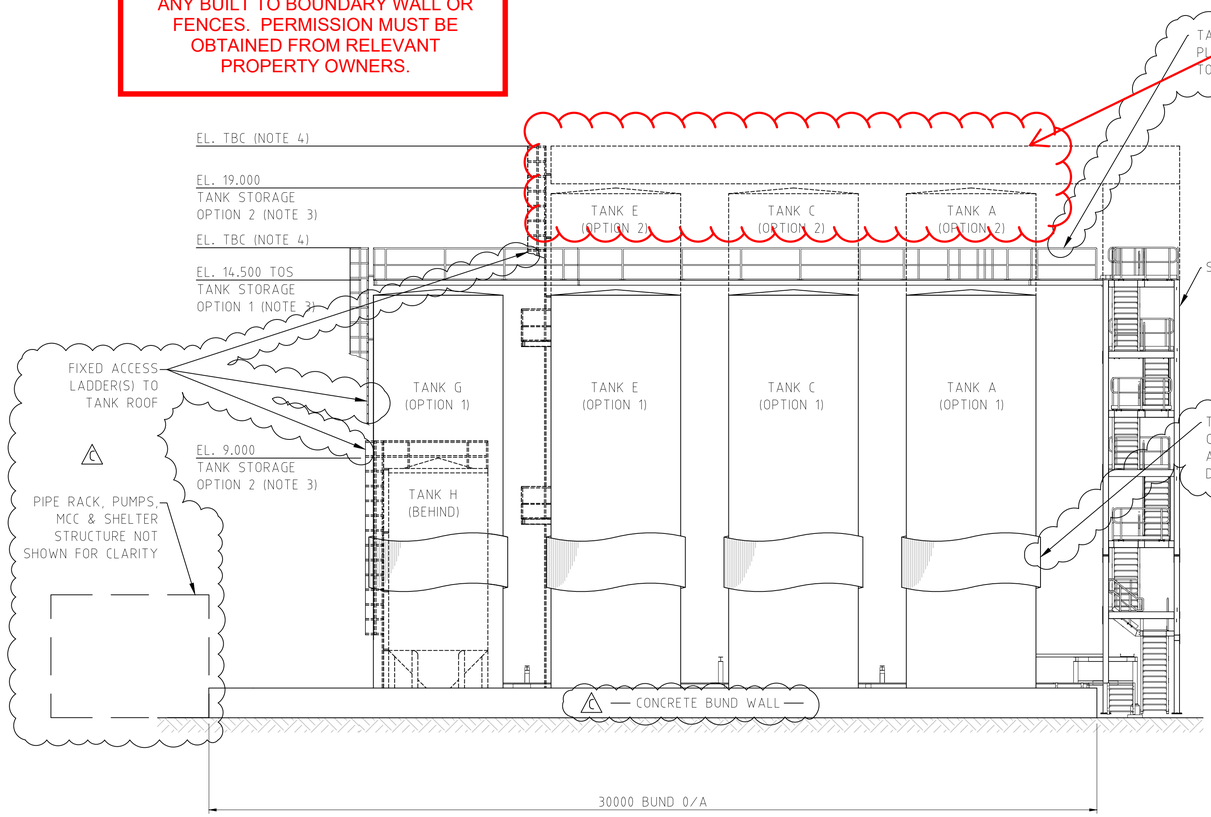

SECTION A 003
SCALE: 1:100

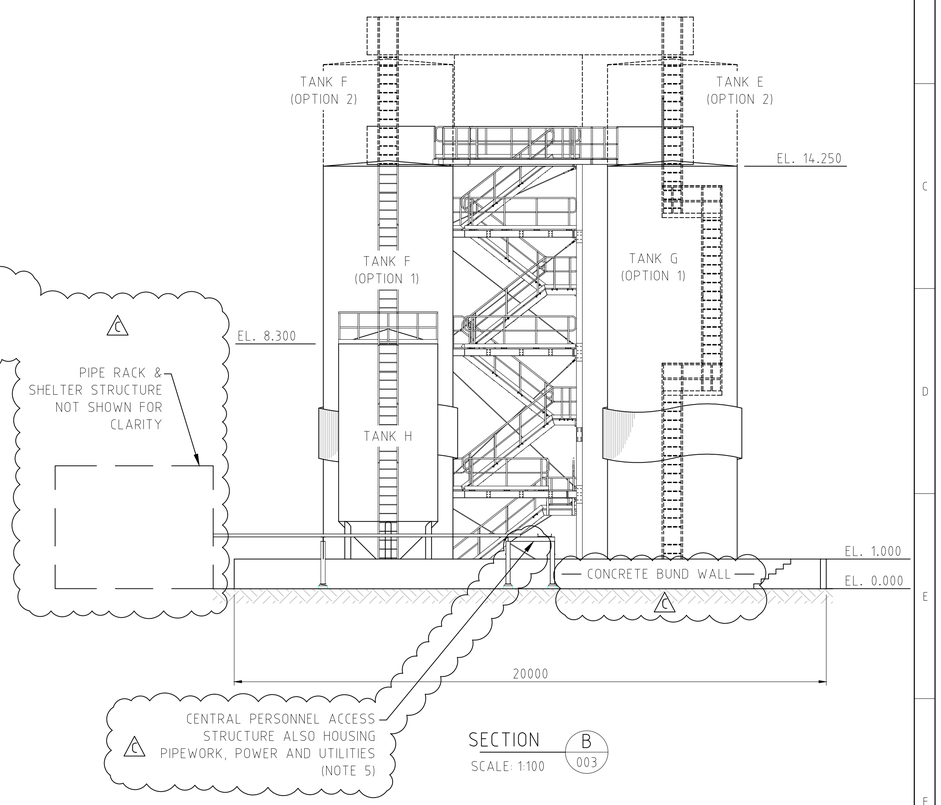

SECTION B 003
SCALE: 1:100

BCC DS
RECEIVED
23-OCT-2026
APPLICATION REF
A007138990

NOTES:
1. PRELIMINARY FOR DEVELOPMENT APPLICATION, NOT FOR TENDER OR CONSTRUCTION.
2. THE PROPOSED SITING OF THE PROPOSED DEVELOPMENT FEATURES IS SUBJECT TO REFINEMENT DURING DETAILED DESIGN PHASE. FINAL DIMENSIONS SUBJECT TO DETAILED DESIGN PHASE.
3. SEE XY24000-02-00-DRG-003 FOR TANK STORAGE OPTIONS DESCRIPTION.
4. ELEVATION TO TOP RAIL IS APPROX, AND WILL ONLY BE AS HIGH AS REQUIRED PENDING FINAL TANK DIMENSIONS AND TANK STORAGE OPTION SELECTION. FINAL ARRANGEMENT MAY VARY BUT SHALL BE SUFFICIENT TO PROVIDE ACCESS TO TANK TOP EQUIPMENT FOR INSPECTION AND MAINTENANCE.
5. PIPING, VALVE, INSTRUMENTATION, SMALL EQUIPMENT NOT SHOWN FOR CLARITY.

PLANS AND DOCUMENTS
referred to in the
APPROVAL
Dated: **11/12/2025**

AMENDED IN RED
28/11/2025

2 1 0 2 4 6 8m
SCALE 1:100

ISSUED FOR DA

REFERENCE DRAWINGS		SPECIFICATIONS	No.	REVISION DESCRIPTION	DATE	DRN	CHK
			C	RE-ISSUED FOR DEVELOPMENT APPLICATION (DA)	06.08.25	DH	ML
XY24000-02-00-DRG-003	FEEDSTOCK STORAGE AREA		B	ISSUED FOR DEVELOPMENT APPLICATION (DA)	19.02.25	AMC	ML
XY24000-02-00-DRG-000	DRAWING LIST FOR DEVELOPMENT APPLICATION		A	ISSUED FOR REVIEW	09.01.25	AMC	ML

AMPOL
Ampol Australia Petroleum Pty Ltd (ABN 17 000 032 128)

COPYRIGHT
THIS DRAWING & DESIGN MUST NOT BE COPIED IN WHOLE OR PART WITHOUT THE WRITTEN CONSENT OF AMPOL AUSTRALIA PETROLEUM PTY LTD.

LYTTON COPROCESSING PROJECT
UNLOADING & STARAGE AREA
ELEVATIONS

MOC. No.	PROJECT No.	EQUIPMENT No.	INDEX.	SIZE.	SITE SAP No.	DRAWING No.	SHEET.	REV.
-	XY24000	-		A1	1124	02-00-DRG-006	0	C

BCC DS
RECEIVED
23-OCT-2026
APPLICATION REF
A007138990

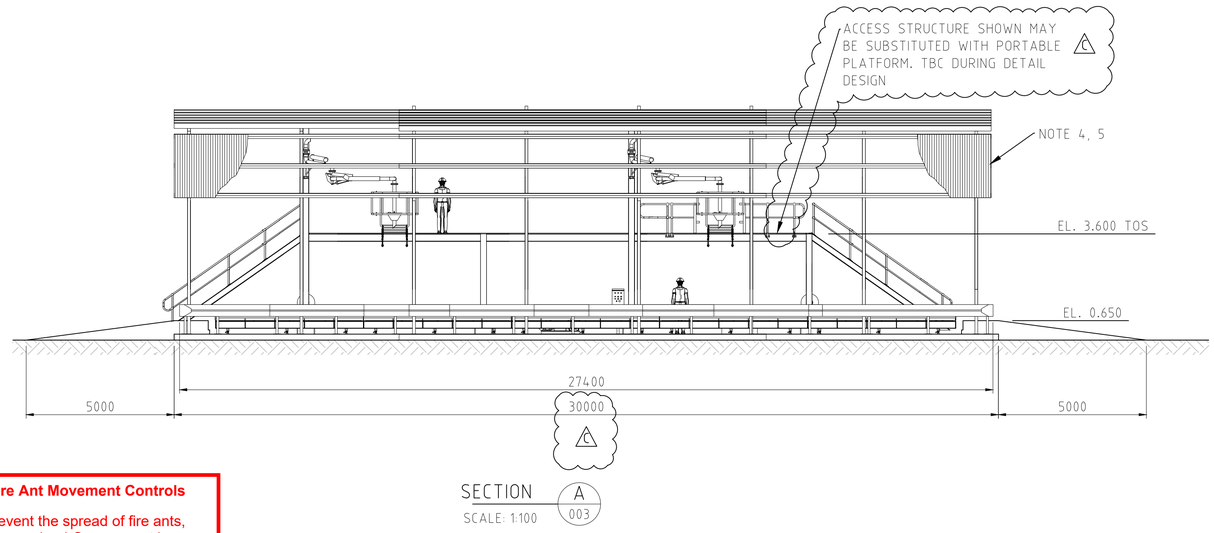

SECTION A
SCALE: 1:100
003

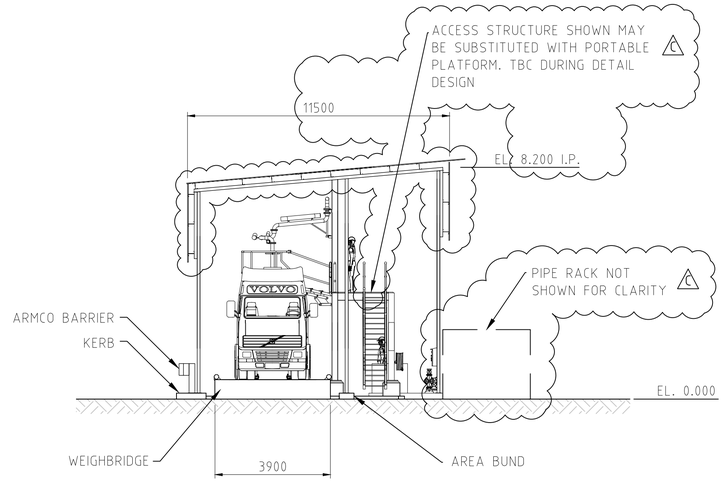

SECTION B
SCALE: 1:100
003

Fire Ant Movement Controls

To prevent the spread of fire ants, the Queensland Government has implemented controls that apply to individuals and commercial operators, to restrict the movement of materials that could carry fire ants including soil, turf, potted plants, mulch, baled hay or straw, animal manures, mining or quarry products.

Penalties apply for non-compliance with the movement controls. If you are unsure of your obligations under the Biosecurity Act 2014 contact the relevant Queensland State Government Department.

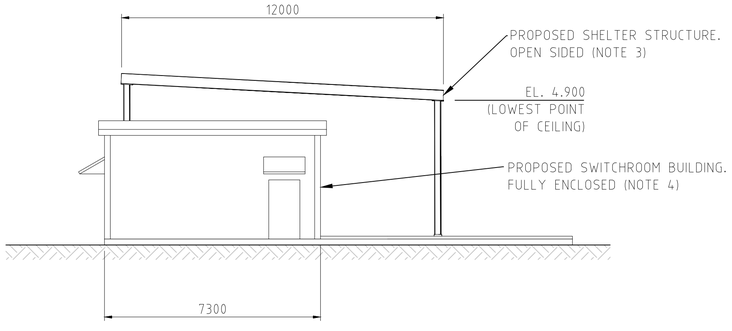

SECTION C
SCALE: 1:100
003

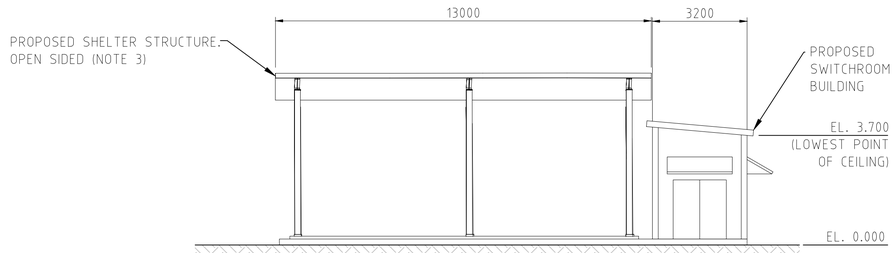

SECTION D
SCALE: 1:100
003

C

NOTES:
1. PRELIMINARY FOR DEVELOPMENT APPLICATION, NOT FOR TENDER OR CONSTRUCTION.
2. THE PROPOSED SITING OF THE PROPOSED DEVELOPMENT FEATURES IS SUBJECT TO REFINEMENT DURING DETAILED DESIGN PHASE. FINAL DIMENSIONS SUBJECT TO COMPLETION OF DETAILED DESIGN PHASE.
3. PIPING, VALVE, INSTRUMENTATION AND SMALL EQUIPMENT NOT SHOWN FOR CLARITY.
4. UNLOADING BAY & SWITCHROOM CLADDING SPECIFICATION, FINISH AND COLOUR TBC IN DETAILED DESIGN.
5. CLADDING REMOVED FOR CLARITY.
6. WEIGHBRIDGE & WEIGHBRIDGE RAMP DIMENSIONS ARE PRELIMINARY (LENGTH, WIDTH, HEIGHT). TO BE CONFIRMED IN DETAILED DESIGN.

C

THIS APPROVAL SHOULD NOT BE TAKEN TO CONSTITUTE PERMISSION TO ENTER NEIGHBOURING PROPERTIES TO CONSTRUCT (INCLUDING ASSOCIATED WORKS SUCH AS DRAINAGE AND EXCAVATION) ANY BUILT TO BOUNDARY WALL OR FENCES. PERMISSION MUST BE OBTAINED FROM RELEVANT PROPERTY OWNERS.

BCC DS
RECEIVED
23/09/2025
APPLICATION REF
A006742055

PLANS AND DOCUMENTS
referred to in the
APPROVAL
Dated: **11/12/2025**

2 1 0 2 4 6 8m
SCALE 1:100

ISSUED FOR DA

REFERENCE DRAWINGS		SPECIFICATIONS	No.	REVISION DESCRIPTION	DATE	DRN	CHK
			C	RE-ISSUED FOR DEVELOPMENT APPLICATION (DA)	06.08.25	DH	ML
XY24000-02-00-DRG-003	FEEDSTOCK STORAGE AREA		B	ISSUED FOR DEVELOPMENT APPLICATION (DA)	19.02.25	AMC	ML
XY24000-02-00-DRG-000	DRAWING LIST FOR DEVELOPMENT APPLICATION		A	ISSUED FOR REVIEW	09.01.25	AMC	ML

AMPOL
Ampol Australia Petroleum Pty Ltd (ABN 17 000 032 128)

COPYRIGHT
THIS DRAWING & DESIGN MUST NOT BE COPIED IN WHOLE OR PART WITHOUT THE WRITTEN CONSENT OF AMPOL AUSTRALIA PETROLEUM PTY LTD.

LYTTON COPROCESSING PROJECT
UNLOADING BAY A
ELEVATIONS

MOC. No.	PROJECT No.	EQUIPMENT No.	INDEX.	SIZE.	SITE SAP No.	DRAWING No.	SHEET.	REV.
-	XY24000	-		A1	1124	02-00-DRG-007	0	C

BCC DS
RECEIVED
23/09/2025
APPLICATION REF
A006742055

THIS APPROVAL SHOULD NOT BE TAKEN TO CONSTITUTE PERMISSION TO ENTER NEIGHBOURING PROPERTIES TO CONSTRUCT (INCLUDING ASSOCIATED WORKS SUCH AS DRAINAGE AND EXCAVATION) ANY BUILT TO BOUNDARY WALL OR FENCES. PERMISSION MUST BE OBTAINED FROM RELEVANT PROPERTY OWNERS.

Fire Ant Movement Controls

To prevent the spread of fire ants, the Queensland Government has implemented controls that apply to individuals and commercial operators, to restrict the movement of materials that could carry fire ants including soil, turf, potted plants, mulch, baled hay or straw, animal manures, mining or quarry products.

Penalties apply for non-compliance with the movement controls. If you are unsure of your obligations under the Biosecurity Act 2014 contact the relevant Queensland State Government Department.

PLANS AND DOCUMENTS
referred to in the
APPROVAL
Dated: **11/12/2025**

BCC DS
RECEIVED
23-OCT-2026
APPLICATION REF
A007138990

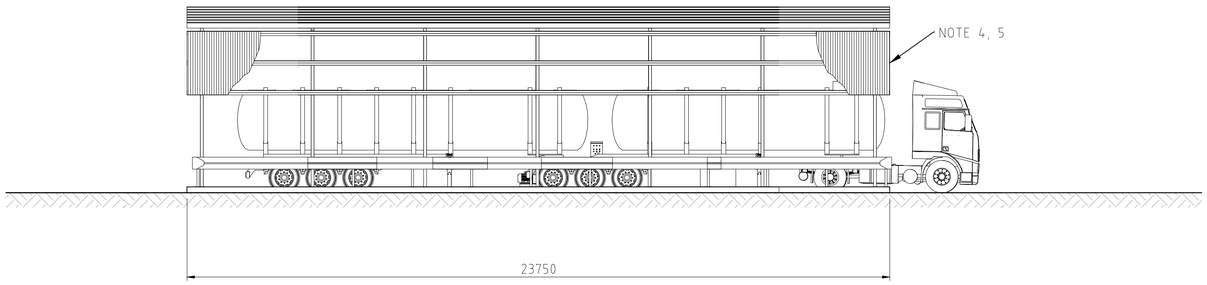

SECTION A
SCALE: 1:100
003

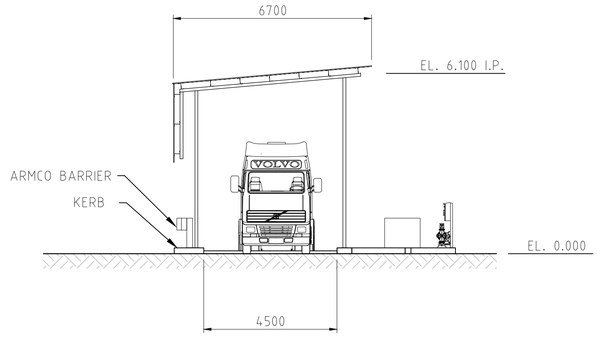

SECTION B
SCALE: 1:100
003

NOTES:
1. PRELIMINARY FOR DEVELOPMENT APPLICATION, NOT FOR TENDER OR CONSTRUCTION.
2. THE PROPOSED SITING OF THE PROPOSED DEVELOPMENT FEATURES IS SUBJECT TO REFINEMENT DURING DETAILED DESIGN PHASE. FINAL DIMENSIONS SUBJECT TO COMPLETION OF DETAILED DESIGN PHASE.
3. PIPING, VALVE, INSTRUMENTATION, SMALL EQUIPMENT NOT SHOWN FOR CLARITY.
4. UNLOADING BAY CLADDING SPECIFICATION, FINISH AND COLOUR TBC IN DETAILED DESIGN.
5. CLADDING REMOVED FOR CLARITY.

2 1 0 2 4 6 8m
SCALE 1:100

ISSUED FOR DA

REFERENCE DRAWINGS		SPECIFICATIONS	No.	REVISION DESCRIPTION	DATE	DRN	CHK
XY24000-02-00-DRG-003	FEEDSTOCK STORAGE AREA		B	ISSUED FOR DEVELOPMENT APPLICATION (DA)	19.02.25	AMC	ML
XY24000-02-00-DRG-000	DRAWING LIST FOR DEVELOPMENT APPLICATION		A	ISSUED FOR REVIEW	09.01.25	AMC	ML

AMPOL
Ampol Australia Petroleum Pty Ltd
(ABN 17 000 032 128)

COPYRIGHT
THIS DRAWING & DESIGN MUST NOT BE COPIED IN WHOLE OR PART WITHOUT THE WRITTEN CONSENT OF AMPOL AUSTRALIA PETROLEUM PTY LTD.

LYTTON COPROCESSING PROJECT
UNLOADING BAY B
ELEVATIONS

MOC. No.	PROJECT No.	EQUIPMENT No.	INDEX.	SIZE.	SITE SAP No.	DRAWING No.	SHEET.	REV.
-	XY24000	-		A1	1124	002-00-DRG-008	0	B

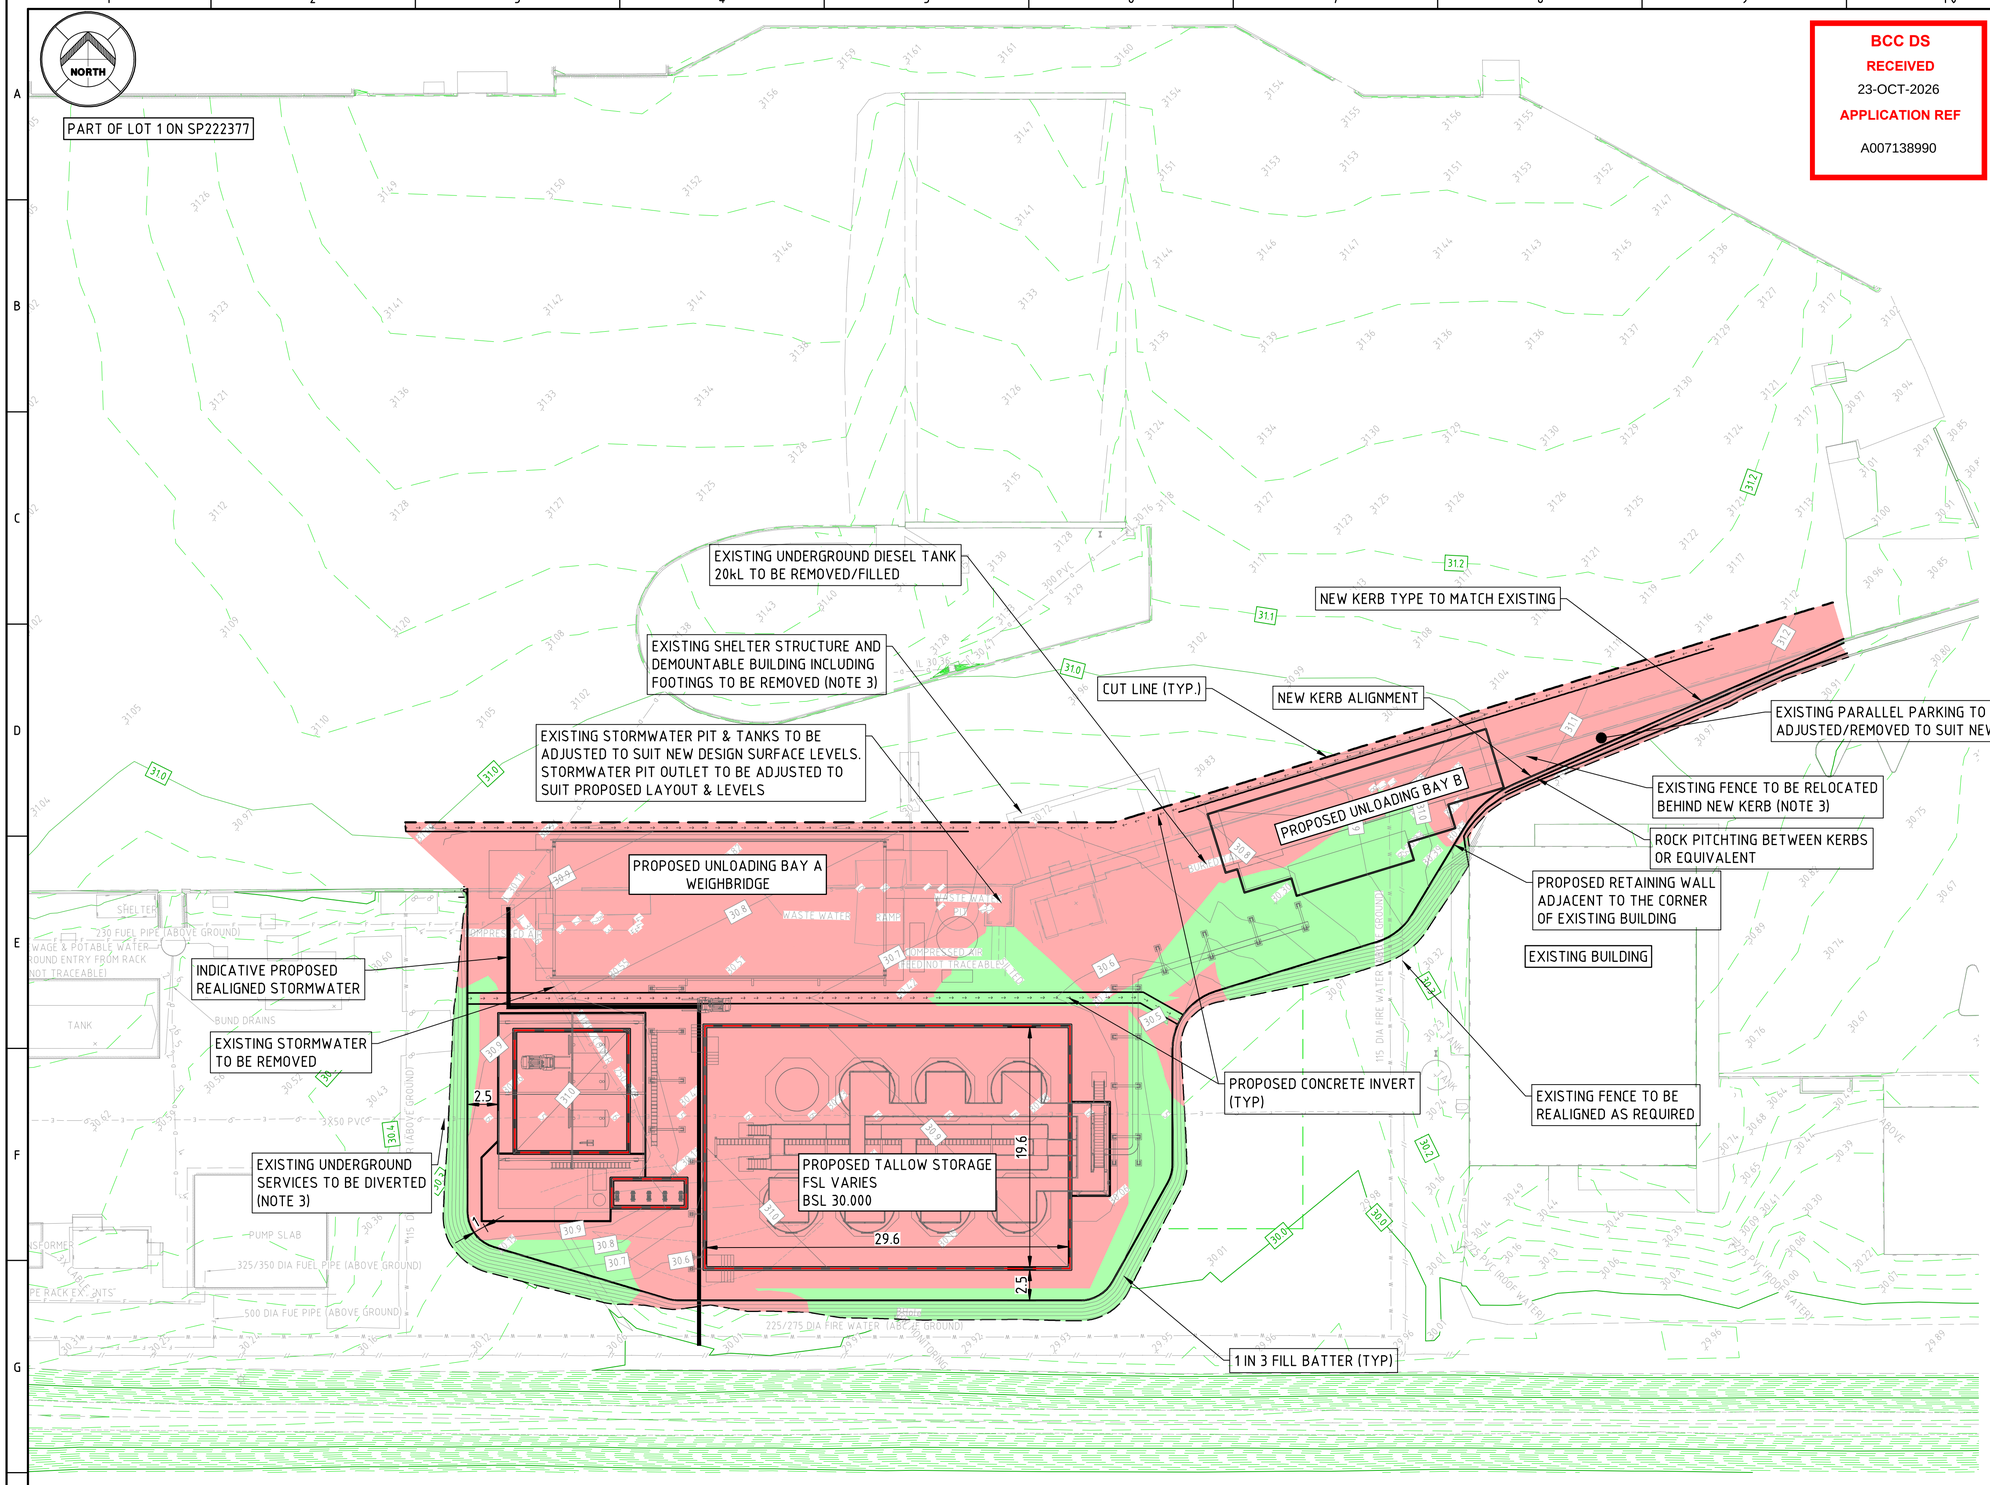

BCC DS
RECEIVED
23-OCT-2026
APPLICATION REF
A007138990

LEGEND
- BULK CUT (1748 m^3)
- BULK FILL (77 m^3)
- EXISTING CONTOURS (0.1m INT)
- DESIGN CONTOURS (0.1m INT)

NOTE:
1. SITE COORDINATE SYSTEM - AMPOL REFINERY GRID
2. CUT FILL IS FOR THE FINAL DEVELOPMENT AND DOES NOT REPRESENT INTERMEDIATE STAGING/CIVIL WORKS
3. UNLESS NOTED OTHERWISE QUANTITIES ARE FOR CIVIL BULKS ONLY AND DO NOT INCLUDE MINOR EXCAVATIONS REQUIRED FOR MINOR STRUCTURES SUCH AS PIPE SUPPORTS, GRUBBING, SERVICES TRENCHING AND DO NOT INCLUDE MINOR FILL FOR REMOVAL OF REDUNDANT SUPPORTS FOR STRUCTURES TO BE REMOVED AS PART OF THE DEMOLITION SCOPE.
4. QUANTITIES ARE INDICATIVE ONLY. SOLID IN PLACE. NO ALLOWANCE FOR EXPANSION (FOR CUT) AND COMPACTION (FOR FILL), UNSUITABLE, TOPSOIL STRIP OR TRENCH/EXISTING PAVEMENT SPOIL. INCLUDES 1500m^3 OF SUBGRADE REPLACEMENT, ASSUMES BOXING 0.35m-1.05m DEEP WITHIN FILTER/TALLOW STORAGE AND 0.3m ELSEWHERE.

Fire Ant Movement Controls

To prevent the spread of fire ants, the Queensland Government has implemented controls that apply to individuals and commercial operators, to restrict the movement of materials that could carry fire ants including soil, turf, potted plants, mulch, baled hay or straw, animal manures, mining or quarry products.

Penalties apply for non-compliance with the movement controls. If you are unsure of your obligations under the Biosecurity Act 2014 contact the relevant Queensland State Government Department.

THIS APPROVAL SHOULD NOT BE TAKEN TO CONSTITUTE PERMISSION TO ENTER NEIGHBOURING PROPERTIES TO CONSTRUCT (INCLUDING ASSOCIATED WORKS SUCH AS DRAINAGE AND EXCAVATION) ANY BUILT TO BOUNDARY WALL OR FENCES. PERMISSION MUST BE OBTAINED FROM RELEVANT PROPERTY OWNERS.

PLANS AND DOCUMENTS
referred to in the
APPROVAL
Dated: 11/12/2025

BCC DS
RECEIVED
23/09/2025
APPLICATION REF
A006742055

0 2.5 7.5 12.5 m
SCALE 1:250 AT ORIGINAL SIZE

D.A ISSUE

RPEQ: TMA 27973

REFERENCE DRAWINGS		SPECIFICATIONS		No.	REVISION DESCRIPTION	DATE	DRN	CHK
				C	REVISED LAYOUT	05/08/25	KER	BCO
				B	D.A ISSUE	27/02/25	JPH	BCO
STD-A11	AMPOL REFINERY LYTTON STANDARD PERMANENT SURVEY			A	PRELIMINARY	19/12/24	KER	BCO
200679-044#002	REV P3 SURVEY							

Ampol Australia Petroleum Pty Ltd (ABN 17 000 032 128)

COPYRIGHT
THIS DRAWING & DESIGN MUST NOT BE COPIED IN WHOLE OR PART WITHOUT THE WRITTEN CONSENT OF AMPOL AUSTRALIA PETROLEUM PTY LTD.

PRELIMINARY
NOT FOR CONSTRUCTION

LYTTON COPROCESSING PROJECT
CIVIL EARTHWORKS
CUT FILL PLAN

MOC. No.	PROJECT No.	EQUIPMENT No.	INDEX.	SIZE.	SITE SAP No.	DRAWING No.	SHEET.	REV.
				A1	1124	02-01-LAY-006	0	C

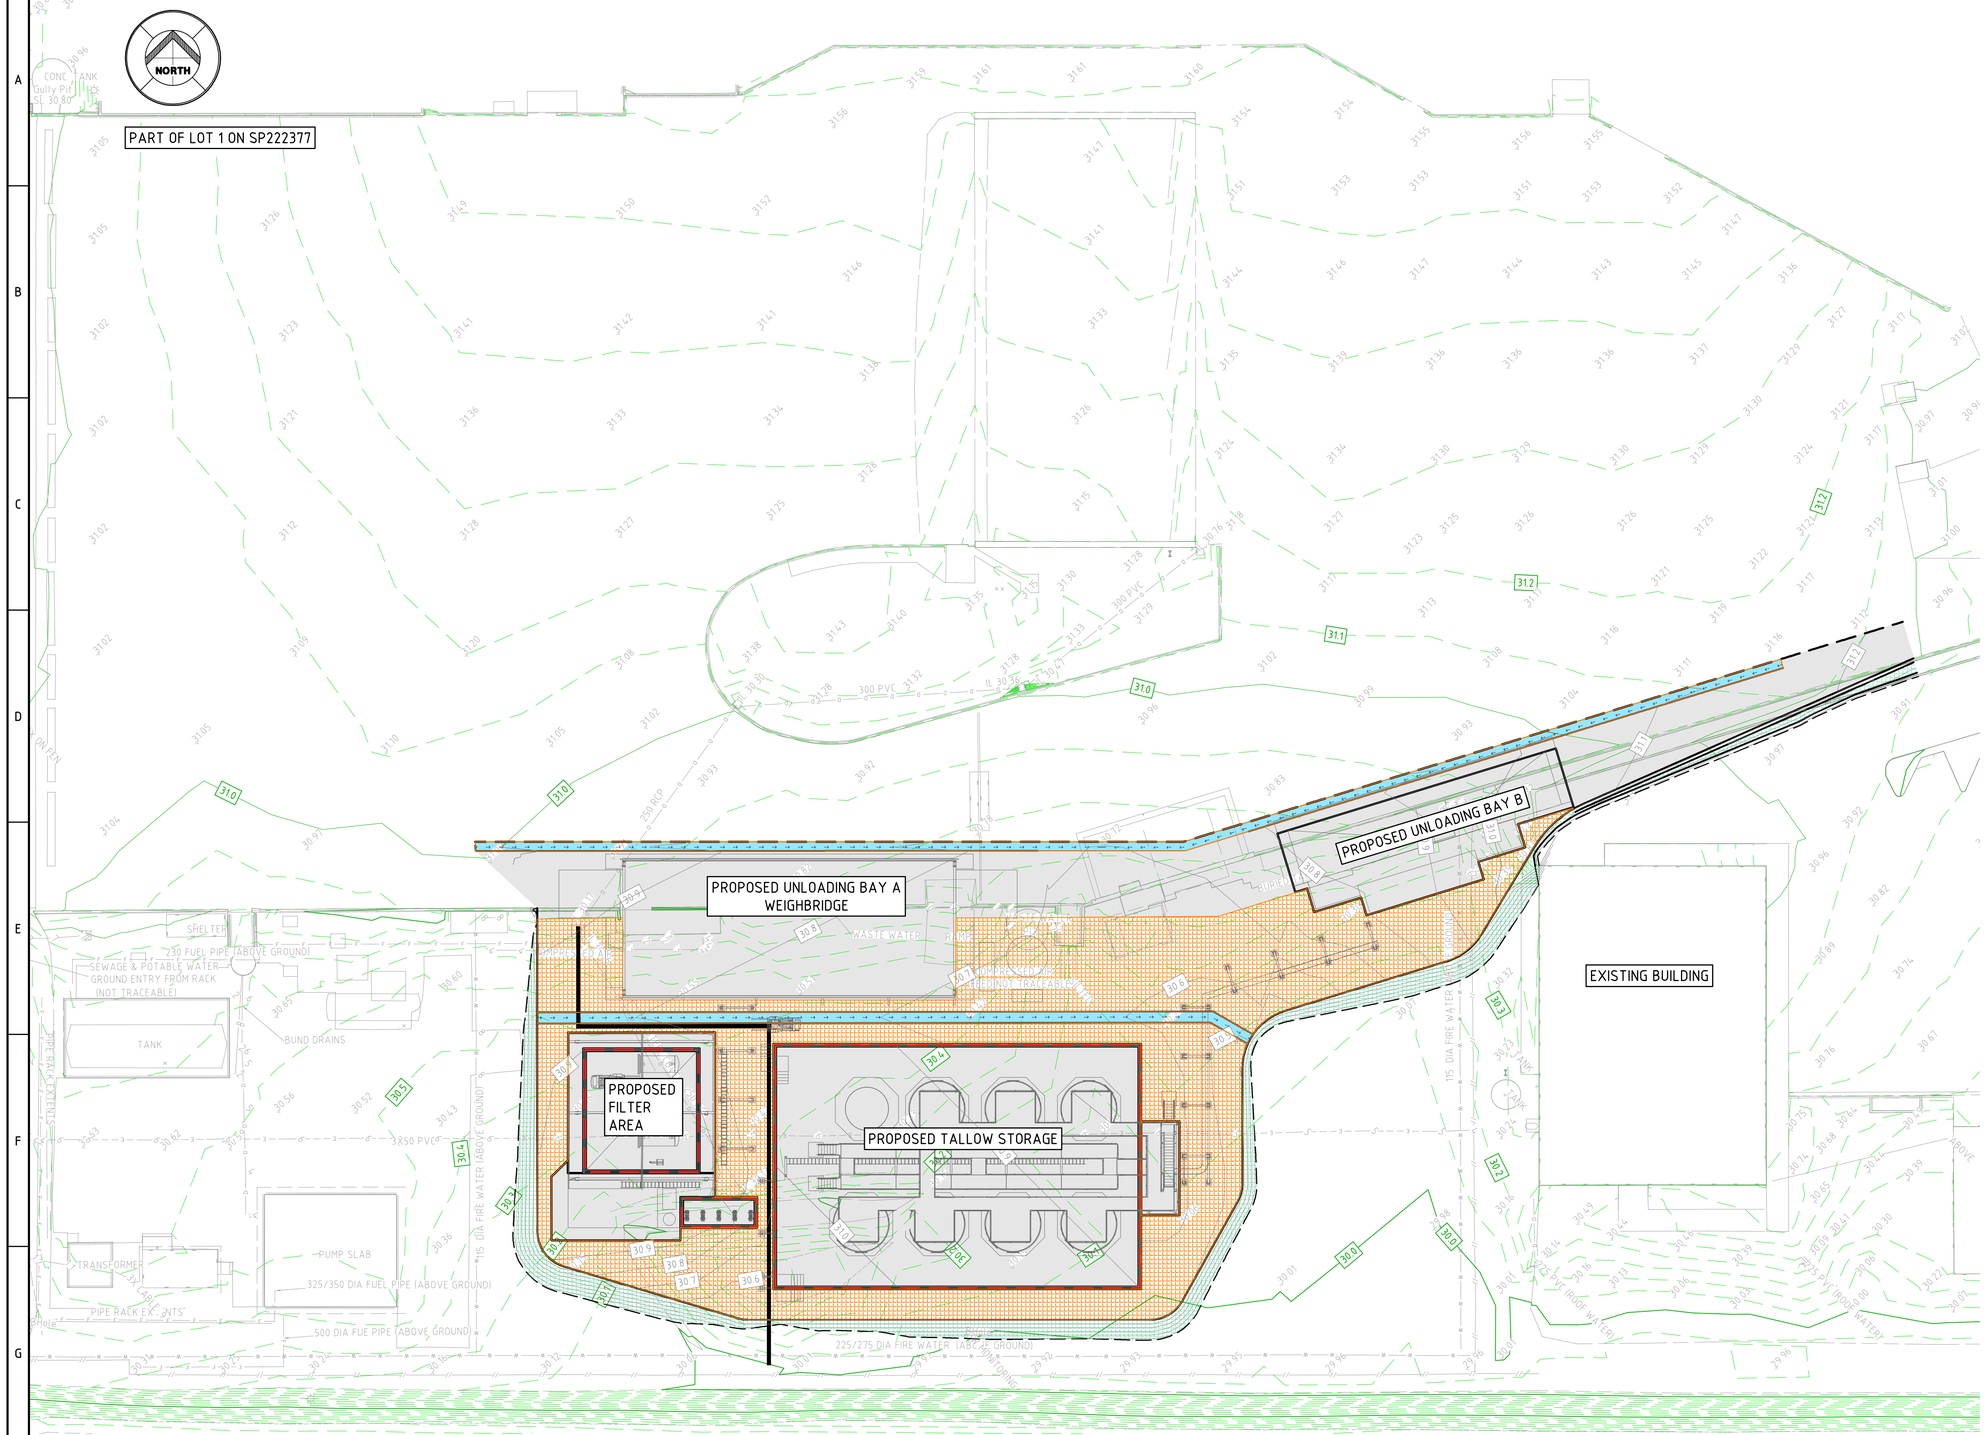

LEGEND

- 898m² OF NEW GRAVEL PAVEMENT (300mm OF CRB80)
- 1696m² OF NEW CONCRETE AREAS (TBC)
- 135m² OF NEW CONCRETE SURFACE DRAIN (TBC)
- 203m² PROPOSED BATTER (FINISH TBC)
- NEW KERB (MATCH EXISTING)

SUMMARY:
IMPERVIOUS - 93%
PERVIOUS - 7%

PLANS AND DOCUMENTS
referred to in the
APPROVAL
Dated: **11/12/2025**

Fire Ant Movement Controls

To prevent the spread of fire ants, the Queensland Government has implemented controls that apply to individuals and commercial operators, to restrict the movement of materials that could carry fire ants including soil, turf, potted plants, mulch, baled hay or straw, animal manures, mining or quarry products.

Penalties apply for non-compliance with the movement controls. If you are unsure of your obligations under the Biosecurity Act 2014 contact the relevant Queensland State Government Department.

THIS APPROVAL SHOULD NOT BE TAKEN TO CONSTITUTE PERMISSION TO ENTER NEIGHBOURING PROPERTIES TO CONSTRUCT (INCLUDING ASSOCIATED WORKS SUCH AS DRAINAGE AND EXCAVATION) ANY BUILT TO BOUNDARY WALL OR FENCES. PERMISSION MUST BE OBTAINED FROM RELEVANT PROPERTY OWNERS.

BCC DS
RECEIVED
23-OCT-2026
APPLICATION REF
A007138990

BCC DS
RECEIVED
23/09/2025
APPLICATION REF
A006742055

0 2.5 7.5 12.5 m
SCALE 1:250 AT ORIGINAL SIZE

D.A ISSUE

RPEQ: TMA 27973

No.	REVISION DESCRIPTION	DATE	DRN	CHK
C	REVISED LAYOUT	05/08/25	KER	BCO
B	D.A ISSUE	27/02/25	JPH	BCO
A	PRELIMINARY	19/12/24	KER	BCO

REFERENCE DRAWINGS
STD-A11 AMPOL REFINERY LYTTON STANDARD PERMANENT SURVEY
200679-044#002 REV P3 SURVEY

SPECIFICATIONS

COPYRIGHT
THIS DRAWING & DESIGN MUST NOT BE COPIED IN WHOLE OR PART WITHOUT THE WRITTEN CONSENT OF AMPOL AUSTRALIA PETROLEUM PTY LTD.

Ampol Australia Petroleum Pty Ltd

PRELIMINARY
NOT FOR CONSTRUCTION

MOC. No. | PROJECT No. | EQUIPMENT No.

LYTTON COPROCESSING PROJECT
CIVIL EARTHWORKS
PAVEMENT PLAN

INDEX.	SIZE.	SITE SAP No.	DRAWING No.	SHEET.	REV.
	A1	1124	02-01-LAY-009	0	C